

**REDUNDANT INFLUENT LINE  
WASTEWATER TREATMENT PLANT  
BURLINGTON, IOWA**

CONTRACTOR'S BID DATE: Tuesday, February 6, 2024 @ 11:00 A.M.

PLACE FOR CONTRACTORS  
TO SUBMIT BIDS: City of Burlington  
City Hall  
400 Washington St  
Burlington, Iowa 52601

OPINION OF CONSTRUCTION COST: \$1,298,000.00

**ADDENDUM NO.2**

February 1, 2024

**TO ALL PLANHOLDERS:**

The following changes, clarifications, additions, and/or deletions are hereby made a part of the contract documents for the above-referenced project, as fully and completely as if the same were fully set forth therein. All Bidders submitting a Bid on the above Contract shall carefully read this Addendum and give it consideration in the preparation of their Bid.

This Addendum No. 2 consists of the following:

- Addendum No. 2 (pages ADN2-1 through ADN2-4)
- Prebid meeting sign-in sheet (1 page)
- Proposal Attachment Part C – Bid Items Quantities and Prices (2 pages)
- Contract Attachment Item 2 – Bid Items Quantities (2 pages)
- Plan Sheet S101 (1 page)
- Plan Sheet P101 (1 page)
- Plan Sheet P302 (1 page)
- Plan Sheet P601 (1 page)

**CLARIFICATIONS:**

1. This project does not require AIS Compliance as it is funded by City funds alone.
2. Classified spaces shown on **SHEET E101**. All electrical components located within these boundaries must comply with Class 1, Division 2 requirements.
3. The 36-inch buried influent pipe was installed after asbestos was typically used, therefore asbestos is not anticipated. Contractors should bid the project assuming that asbestos is not present in this buried pipe. The 36-inch pipe can be removed, sampled for asbestos, as necessary, and stored onsite while waiting for results prior to disposal to limit delays waiting for sample results and minimize time needed for plant bypass.

4. **BID ITEM 11.03 CONCRETE PIPE SUPPORTS** includes the entire pipe support that is located on the exterior of the Headworks Building.
5. **BID ITEM 11.06 STEEL PIPE SUPPORTS (STAINLESS)** includes pipe supports located on the interior of the Headworks Building.
6. **SECTION 26 0533.13 CONDUIT FOR ELECTRICAL SYSTEMS:**
  - a. Contractor to select appropriate conduit based on the location and classification of the area conduit is located in accordance with this specification.
7. There shall be no buried dismantling joints. All buried dismantling joints have been removed from the project. Two (2) buried 36-inch DIP sleeves have been added. See revised **SHEET P101**(attached), revised **SHEET P302** (attached) and revised **SHEET P601** (attached) for changes. **SHEETS C101** and **C102** have not been updated to reflect these changes. The changes will be included on all plan sheets when the Conformed Construction Documents are issued to the Contractor after the project is awarded. The 20-inch DIP Flanged dismantling joint remains a part of the project. Summary of changes include the following:
  - a. Replace the 36" dismantling joints with spool pieces.
  - b. Add two 36" sleeves.
  - c. Delete 20" DI MJ Dismantling Joint.
  - d. Delete 12" DI MJ Dismantling Joint.
  - e. Delete 6" DI MJ Dismantling Joint.

**SPECIFICATIONS:**

1. **REPLACE PROPOSAL ATTACHMENT PART C – BID ITEMS QUANTITIES AND PRICES WITH THE ATTACHED** (Changes Highlighted)
2. **REPLACE CONTRACT ATTACHMENT ITEM 2 – BID ITEMS QUANTITIES WITH THE ATTACHED** (Changes Highlighted)
3. **SECTION 01 1000 SUMMARY:**
  - a. **REPLACE 1.02.B.1** with "Contact: Don Fitting"
  - b. **REPLACE 1.02.B.3** with "Telephone: 319-753-8157"
  - c. **REPLACE 1.05.E.2.a** with "The Owner reserves the right employ others to stop any unexpected or unplanned bypassing caused by the Contractor without giving notice to Contractor and recover from the Contractor all costs incurred by the Owner as a result of the bypass including labor, materials, services, legal fees, regulatory penalties, and other related expenses."
  - d. **ADD 1.08.A.1** "Owner will dewater the influent chamber. The contractor is responsible for dewatering/drainage the buried 36-inch influent pipe prior to cutting the pipe and



installing the new pipe, fittings and valves. All flow shall be pumped to the grit chamber.”


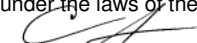
4. **SECTION 05 5100 METAL STAIRS:**
  - a. **REPLACE** 1.05A with “Contractor to provide shop drawings for review to engineer of record. Contractor to verify that ladder and stair configuration as shown in shop drawings do not create a conflict with existing or proposed piping or structures.”
5. **SECTION 22 1116 DUCTILE IRON PIPE:**
  - a. **ADD** 2.02.B Inside Lining, “Lining is required for all DIP pipe and fittings.”
  - b. **ADD** 2.05.D Outside Coating, “Coating is required for pipe and fittings.”
6. **SECTION 26 0533.13 CONDUIT FOR ELECTRICAL SYSTEMS:**
  - a. Contractor to select appropriate conduit based on the location and classification of the area conduit is located in accordance with this specification.

**PLANS:**

1. **SHEET G003 ESTIMATE PROJECT QUANTITIES:**
  - a. **REPLACE** Item No. 4.07 Item Description with “VENT PIPE, ABOVE GRADE, FLANGED DIP, 3-INCH”
  - b. **REPLACE** Item No. 4.08 Item Description with “DIP, 3-INCH FITTINGS”
  - c. **REPLACE** Item No. 7.03 PLAN QUANTITY with “109”
  - d. **REPLACE** Item No. 7.04 PLAN QUANTITY with “109”
2. **G004 ESTIMATE REFERENCE INFORMATION:**
  - a. **REPLACE** Item No. 4.07 Item Description with “VENT PIPE, ABOVE GRADE, FLANGED DIP, 3-INCH”
  - b. **REPLACE** Item No. 4.08 Item Description with “DIP, 3-INCH FITTINGS”
  - c. **ADD** Item No. 4.19 Plug Valve, 36-inch D. “Dewatering/draining of influent 36-inch line shall be incidental to this bid item.”
3. **REFER TO SHEET P302, DETAIL 3**
  - a. **REPLACE** 2-inch DIP and DIP fittings with 3-inch DIP and DIP fittings for the vent pipe
4. **SHEET S001, DETAIL 4**
  - a. Wall thickness for all wall penetrations is 1’-0”. Two (2) sets of mechanical seals shall be provided for each penetration.
5. **REPLACE PLAN SHEET S101 WITH THE ATTACHED** (there are no changes to the design)
6. **REPLACE PLAN SHEET P601 WITH THE ATTACHED** (See the updated fitting table)

All bidders shall acknowledge receipt and acceptance of Addendum No. 2 by signing in the space provided on the Bid Form. Bids submitted without Addendum No. 2 being acknowledged will be considered non-responsive.

	I hereby certify that this engineering document was prepared by me or under my direct personal supervision and that I am a duly licensed Professional Engineer under the laws of the State of Iowa.
	 Date: 2/01/24
	<b>MATTHEW JOHN WILDMAN, P.E.</b>
	License No. <b>17910</b>
	My renewal date is <b>December 31, 2025</b>
Pages or sheets covered by this seal: <b>Addendum #2</b>	

	I hereby certify that this engineering document was prepared by me or under my direct personal supervision and that I am a duly licensed Professional Engineer under the laws of the State of Iowa.
	 Date: 2/01/24
	<b>CRISTIAN A. APARICIO, P.E.</b>
	License No. <b>28010</b>
	My renewal date is <b>December 31, 2024.</b>
Pages or sheets covered by this seal: <b>Addendum #2</b>	

MATTHEW J. WILDMAN, PE  
HR GREEN, INC.  
8710 EARHART LANE  
CEDAR RAPIDS, IOWA 52404  
PHONE: (319) 841-4000

**END OF ADDENDUM #2**



## MEETING SIGN-IN SHEET

Project Name: Redundant Influent Line Wastewater Treatment Facility

Project Job Number: 220608

Date: January 23, 2024 Time: 11:00 AM

Location: WWTF

Name (Please Print)	Representing	Phone Number	E-Mail Address
Tim Myatt	WWTF	319-753-8157	<a href="mailto:myattt@burlingtoniowa.org">myattt@burlingtoniowa.org</a>
Tim Brown	Bessine Electric	319-752-6046	<a href="mailto:timebrown@yahoo.com">timebrown@yahoo.com</a>
Mike Brown	Bessine Electric	319-572-1448	<a href="mailto:Msbrown9178@gmail.com">Msbrown9178@gmail.com</a>
Corey Baker	Keokuk Contractors	319-795-0996	<a href="mailto:coreybaker@keokukcontractors.com">coreybaker@keokukcontractors.com</a>
Bob Roy	Keokuk Contractors	319-759-2488	<a href="mailto:bobroy@keokukcontractors.com">bobroy@keokukcontractors.com</a>
Skyler Troutman	Klingner & Associates	319-671-2574	<a href="mailto:stroutman@klingner.com">stroutman@klingner.com</a>
Jared Prickett	Frank Millard	319-768-6599	<a href="mailto:jaredp@frankmillard.com">jaredp@frankmillard.com</a>
Thomas Schelich	Frank Millard	319-759-2364	<a href="mailto:ts@frankmillard.com">ts@frankmillard.com</a>
Connor Beals	Frank Millard	319-759-9506	<a href="mailto:connor@frankmillard.com">connor@frankmillard.com</a>
Don Fitting	WWTF	319-753-8157	<a href="mailto:fittingd@burlingtoniowa.org">fittingd@burlingtoniowa.org</a>
Brooke Thye	Indiana, Illinois, Iowa Foundation for Fair Contracting	708-638-3339	<a href="mailto:bthye@illffc.org">bthye@illffc.org</a>
Matt Wildman	HR Green	319-841-4320	<a href="mailto:mwildman@hrgreen.com">mwildman@hrgreen.com</a>

**PROPOSAL  
REDUNDANT INFLUENT LINE  
WASTEWATER TREATMENT FACILITY  
BURLINGTON, IA**

**PROPOSAL ATTACHMENT: PART C – BID ITEMS, QUANTITIES AND PRICES**

This is a UNIT BID PRICE CONTRACT. The bidder must provide the Unit Bid Price, the Total Bid Price, and the Total Construction Cost; in case of discrepancy, the Unit Bid Price governs. The quantities shown on the Proposal Attachment: Part C – Bid Items, Quantities and Prices are approximately only, but are considered sufficiently adequate for the purpose of comparing bids. The Jurisdiction shall only use the Total Construction Cost for comparison of bids.

ITEM NO.		UNIT	QUANTITY	UNIT PRICE	TOTAL
1.	Sanitary Sewer Force Main, Trenched, MJ RJ DIP, 4-Inch	LF	6	\$	\$
2.	Sanitary Sewer Force Main, Trenched, MJ RJ DIP, 6-Inch	LF	11		
3.	Sanitary Sewer Force Main, Trenched, MJ RJ DIP, 12-Inch	LF	8		
4.	Sanitary Sewer Force Main, Trenched, MJ RJ DIP, 20-Inch	LF	46		
5.	Sanitary Sewer Force Main, Trenched, MJ RJ DIP, 36-Inch	LF	6		
6.	Sanitary Sewer Force Main, Above Grade, Flanged DIP, 20-Inch	LF	72		
7.	Vent Pipe, Above Grade, Flanged DIP, 3-Inch	LF	37		
8.	DIP, 3-Inch Fittings	LS	1		
9.	DIP, 4-Inch Fittings	LS	1		
10.	DIP, 6-Inch Fittings	LS	1		
11.	DIP, 12-Inch Fittings	LS	1		
12.	DIP, 20-Inch Fittings	LS	1		
13.	DIP, 36-Inch Fittings	LS	1		
14.	Interior Plumbing Reroute	EA	2		
15.	Plug Valve, 6-Inch	EA	3		
16.	Plug Valve, 12-Inch	EA	2		
17.	Plug Valve, 20-Inch	EA	4		
18.	Modulating Valve, 20-Inch	EA	1		
19.	Actuated Valve, 20-Inch	EA	1		
20.	Plug Valve, 36-Inch	EA	1		
21.	Heat Tape System & Insulation for Freeze Protection	LS	1		
22.	Curb and Gutter 6 in x 18 in	LF	45		

ITEM NO.		UNIT	QUANTITY	UNIT PRICE	TOTAL
23.	Removal of Curb	LF	45		
24.	Full Depth Patches, PCC, 9-Inch	SY	109		
25.	Pavement Removal	SY	109		
26.	Hydraulic Seeding, Seeding, Fertilizing, and Mulching, Type 1	AC	0.05		
27.	Removal and Reinstallation of Existing Fence	LF	45		
28.	Demolition	LS	1		
29.	Mobilization	LS	1		
30.	Core Pipe in Existing Structure	EA	4		
31.	Concrete Pipe Supports	EA	8		
32.	SS Baffle	LS	1		
33.	Bollards	EA	5		
34.	Steel Pipe Supports (Stainless)	EA	3		
35.	Stairs	LS	1		
36.	Partial Magnetic Flow Meter	EA	1		
37.	Radar Level Transmitter	EA	1		
38.	Existing Control Panel Modifications and Programming	LS	1		
39.	Redundant Line Electrical	LS	1		
<b>Total</b>					

NOTE: IT IS UNDERSTOOD THAT THE ABOVE QUANTITIES ARE ESTIMATED FOR THE PURPOSE OF THIS BID. ALL QUANTITIES ARE SUBJECT TO REVISION BY THE CITY. QUANTITY CHANGES WHICH AMOUNT TO TWENTY (20) PERCENT OR LESS OF THE TOTAL BID SHALL NOT AFFECT THE UNIT PRICE BID.

\_\_\_\_\_  
Bidder

**CONTRACT ATTACHMENT: ITEM 2: BID ITEMS, QUANTITIES**

THIS CONTRACT IS AWARDED AND EXECUTED FOR COMPLETION OF THE WORK SPECIFIED IN THE CONTRACT DOCUMENTS FOR THE BID PRICES TABULATED BELOW AS PROPOSED BY THE CONTRACTOR IN ITS PROPOSAL SUBMITTED IN ACCORDANCE WITH NOTICE TO BIDDERS AND NOTICE OF PUBLIC HEARING. ALL QUANTITIES ARE SUBJECT TO REVISION BY THE JURISDICTION. BASED ON BIDS RECEIVED, THE CITY RESERVES THE RIGHT TO ADJUST QUANTITIES AS NECESSARY TO MAXIMIZE FUNDS BUDGETED FOR THIS PROJECT.


ITEM NO.		UNIT	QUANTITY	UNIT PRICE	TOTAL
1.	Sanitary Sewer Force Main, Trenched, MJ RJ DIP, 4-Inch	LF	6	\$	\$
2.	Sanitary Sewer Force Main, Trenched, MJ RJ DIP, 6-Inch	LF	11		
3.	Sanitary Sewer Force Main, Trenched, MJ RJ DIP, 12-Inch	LF	8		
4.	Sanitary Sewer Force Main, Trenched, MJ RJ DIP, 20-Inch	LF	46		
5.	Sanitary Sewer Force Main, Trenched, MJ RJ DIP, 36-Inch	LF	6		
6.	Sanitary Sewer Force Main, Above Grade, Flanged DIP, 20-Inch	LF	72		
7.	Vent Pipe, Above Grade, Flanged DIP, 3-Inch	LF	37		
8.	DIP, 3-Inch Fittings	LS	1		
9.	DIP, 4-Inch Fittings	LS	1		
10.	DIP, 6-Inch Fittings	LS	1		
11.	DIP, 12-Inch Fittings	LS	1		
12.	DIP, 20-Inch Fittings	LS	1		
13.	DIP, 36-Inch Fittings	LS	1		
14.	Interior Plumbing Reroute	EA	2		
15.	Plug Valve, 6-Inch	EA	3		
16.	Plug Valve, 12-Inch	EA	2		
17.	Plug Valve, 20-Inch	EA	4		
18.	Modulating Valve, 20-Inch	EA	1		
19.	Actuated Valve, 20-Inch	EA	1		
20.	Plug Valve, 36-Inch	EA	1		
21.	Heat Tape System & Insulation for Freeze Protection	LS	1		
22.	Curb and Gutter 6 in x 18 in	LF	45		
23.	Removal of Curb	LF	45		
24.	Full Depth Patches, PCC, 9-Inch	SY	109		
25.	Pavement Removal	SY	109		



ITEM NO.		UNIT	QUANTITY	UNIT PRICE	TOTAL
26.	Hydraulic Seeding, Seeding, Fertilizing, and Mulching, Type 1	AC	0.05		
27.	Removal and Reinstallation of Existing Fence	LF	45		
28.	Demolition	LS	1		
29.	Mobilization	LS	1		
30.	Core Pipe in Existing Structure	EA	4		
31.	Concrete Pipe Supports	EA	8		
32.	SS Baffle	LS	1		
33.	Bollards	EA	5		
34.	Steel Pipe Supports (Stainless)	EA	3		
35.	Stairs	LS	1		
36.	Partial Magnetic Flow Meter	EA	1		
37.	Radar Level Transmitter	EA	1		
38.	Existing Control Panel Modifications and Programming	LS	1		
39.	Redundant Line Electrical	LS	1		
<b>Total</b>					


- GENERAL GRATING NOTES:**
- IF NO GRATING SIZE IS INDICATED ON DRAWINGS, USE GRATING SIZE BASED ON MAXIMUM SPAN TABULATED IN TABLES. ADD 1/4" THICKNESS TO ALL SERRATED BAR GRATING.
  - ALL GRATING SHALL BE BANDED AT ENDS AND OPENINGS.
  - ALL SMOOTH-SURFACE BAR GRATE SHALL HAVE A SLIP-RESISTANT EPOXY/GRIT COATING ON ALL GRATING TOP SURFACES.
  - BAR GRATE SHALL BE DESIGNED FOR UNIFORM LOAD OR POINT LOAD, WHICHEVER PRODUCES THE GREATEST EFFECT.
    - 100PSF OR 300LB
    - 125PSF OR 2,000LB OVER 2.5'X2.5' AREA
    - 250PSF OR 3,000LB OVER 2.5'X2.5' AREA
- ALUMINUM GRATING NOTES:**
- ALUMINUM GRATING IS RECT BEARING BARS, 19-S-4, SMOOTH-SURFACE UNO.
  - STEEL ANGLES, FASTENERS, BARS, & CONCRETE ANCHORS BE TYPE 316 STAINLESS STEEL.

100 PSF ALUMINUM GRATING TABLE			
ALUMINUM GRATING THICKNESS "T"	MAX SPAN (FT)	ANCHOR DIA	ANCHOR SPACING
1	3.5	3/8"	16"
1 1/2	4.5	1/2"	24"
2	6.0	1/2"	24"
2 1/2	7.0	1/2"	24"

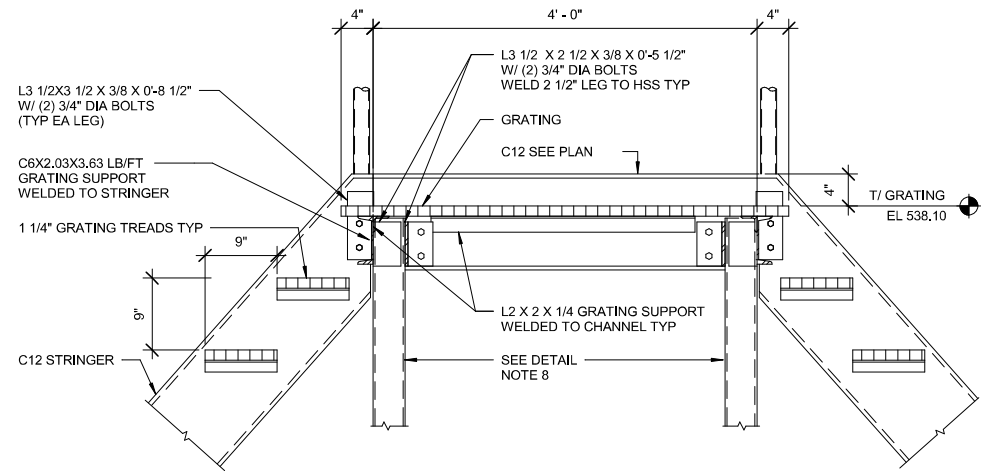


- PLATFORM, RAILING AND STAIR NOTES:**
- ALL CHANNELS, ANGLES, HSS COLUMNS AND PLATES TO BE ALUMINUM.
  - SEE PLANS FOR ALL OTHER DIMENSIONS NOT SHOWN.
  - STAIRS ARE 3'-0" WIDE BACK TO BACK OF CHANNELS, UNO, STRINGERS AND PLATFORM CHANNELS ARE C12X3X7.4 LB/FT UNO ON PLANS.
  - ALL GRATING AND STAIR TREADS TO BE SERRATED ALUMINUM UNO.
  - 6" CHANNELS (WHERE INDICATED) ARE C6X2X3 LB/FT.
  - ALL CONNECTIONS ARE WELDED OR BOLTED WITH MIN (2) 3/4" DIA STAINLESS STEEL BOLTS.
  - PROVIDE 2 1/2 X 2 1/2 X 1/4 DIA BRACING BETWEEN BOTTOM FLANGES OF STRINGERS FOR ALL HORIZ STAIR SPANS GREATER THAN 8'-0". APPLIES TO ALL STAIRS ON PROJECT.
  - HSS4X4X3/8 ALUMINUM COLUMN WITH BASE PLATE 1/2" X 9" X 0'-9" AND (4) 3/4" DIA ANCHORS WITH 1" NON SHRINK GROUT.


**1 TOP OF STAIR LANDING AND PLATFORM DETAIL**  
SCALE: 1" = 1'-0"

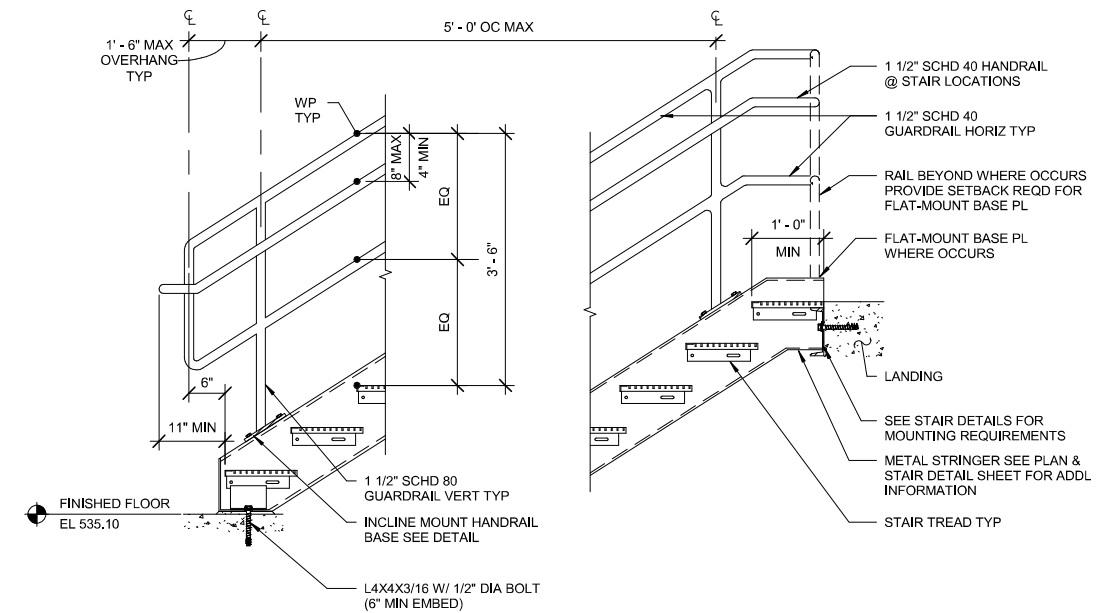


**2 ALUMINUM STAIR RAIL (2 HORIZ) ELEVATION**  
SCALE: 3/4" = 1'-0"

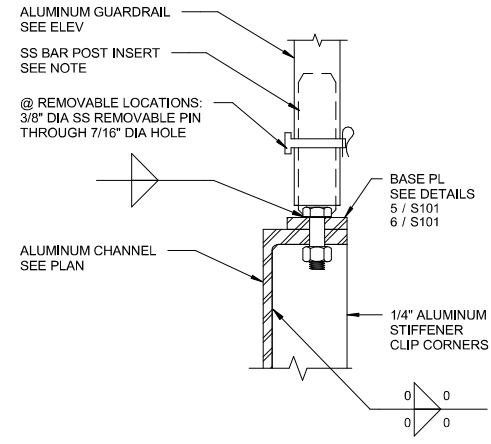


**3 ALUMINUM @ ALUMINUM CHANNEL**  
SCALE: 3" = 1'-0"

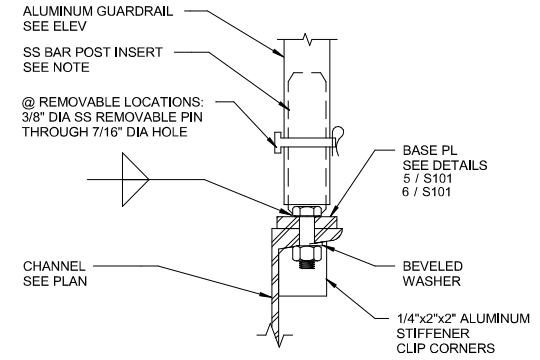

**4 ALUMINUM @ STEEL CHANNEL**  
SCALE: 3" = 1'-0"

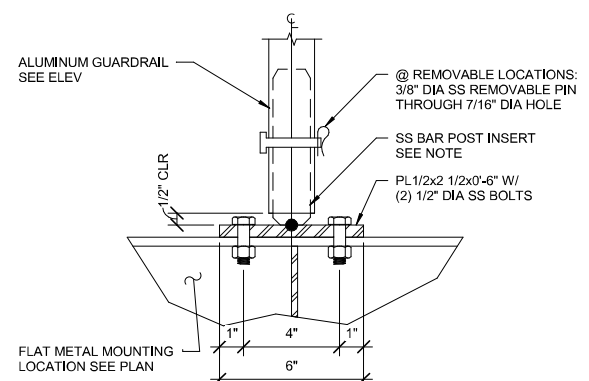

**5 ALUMINUM FLAT MOUNT**  
SCALE: 3" = 1'-0"

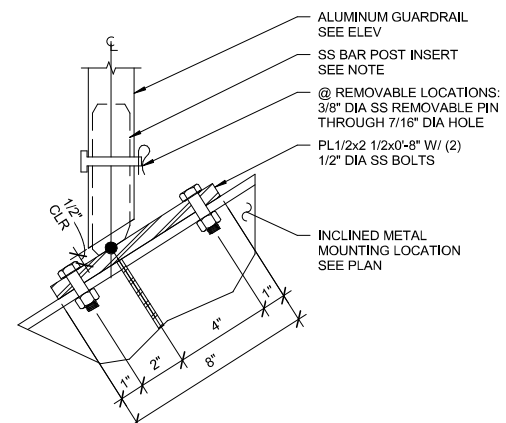

**6 ALUMINUM INCLINED MOUNT**  
SCALE: 3" = 1'-0"

1/4/2024 BID SET

FILE: C:\Users\meath\Documents\220608\_S\_v21\_melody.meah\UX\ZB.rvt PLOTTED: 12/12/2023 2:18:02 PM

DRAWN BY: MLM	BAR IS ONE INCH ON OFFICIAL DRAWINGS
APPROVED: CAA	IF NOT ONE INCH, ADJUST SCALE ACCORDINGLY
JOB DATE: 2023	
JOB NUMBER: 220608	

NO	DATE	BY	REVISION DESCRIPTION
	11/03/23		PERMIT SET




REDUNDANT INFLUENT LINE  
WASTEWATER TREATMENT FACILITY  
BURLINGTON, IOWA

STRUCTURAL  
PLATFORM AND STAIR DETAILS

SHEET NO.  
**S101**

- NOTES:
1. SEE SHEET P601 FOR VALVE AND FITTING INFORMATION.
  2. REFER TO E-SHEETS AND SPECIFICATION 22 0533 FOR HEAT TRACING REQUIREMENTS.
  3. BURIED DIP SHALL BE RESTRAINED JOINT.
  4. ABOVE GRADE DIP SHALL BE FLANGED. SEE STRUCTURAL SHEETS FOR PIPE SUPPORTS.
  5. CONTRACTOR TO VERIFY THE LOCATIONS OF PIPE SUPPORTS TO ENSURE THAT NO UTILITY CONFLICTS EXIST WITH PROPOSED LOCATIONS OF PIPE SUPPORT.

- ⓧ SHEET P101 KEY NOTES
1. EXTEND PIPING TO 4" BELOW GRADE. CAP WITH BLIND FLANGE AND INSTALL STANDARD DUTY CASTING MARKED "SANITARY" PER SUDAS SW-203.
  2. INSTALL RJ CAP. MARK CAP WITH BURIED 4x4 POST EXTENDED JUST BELOW GRADE.

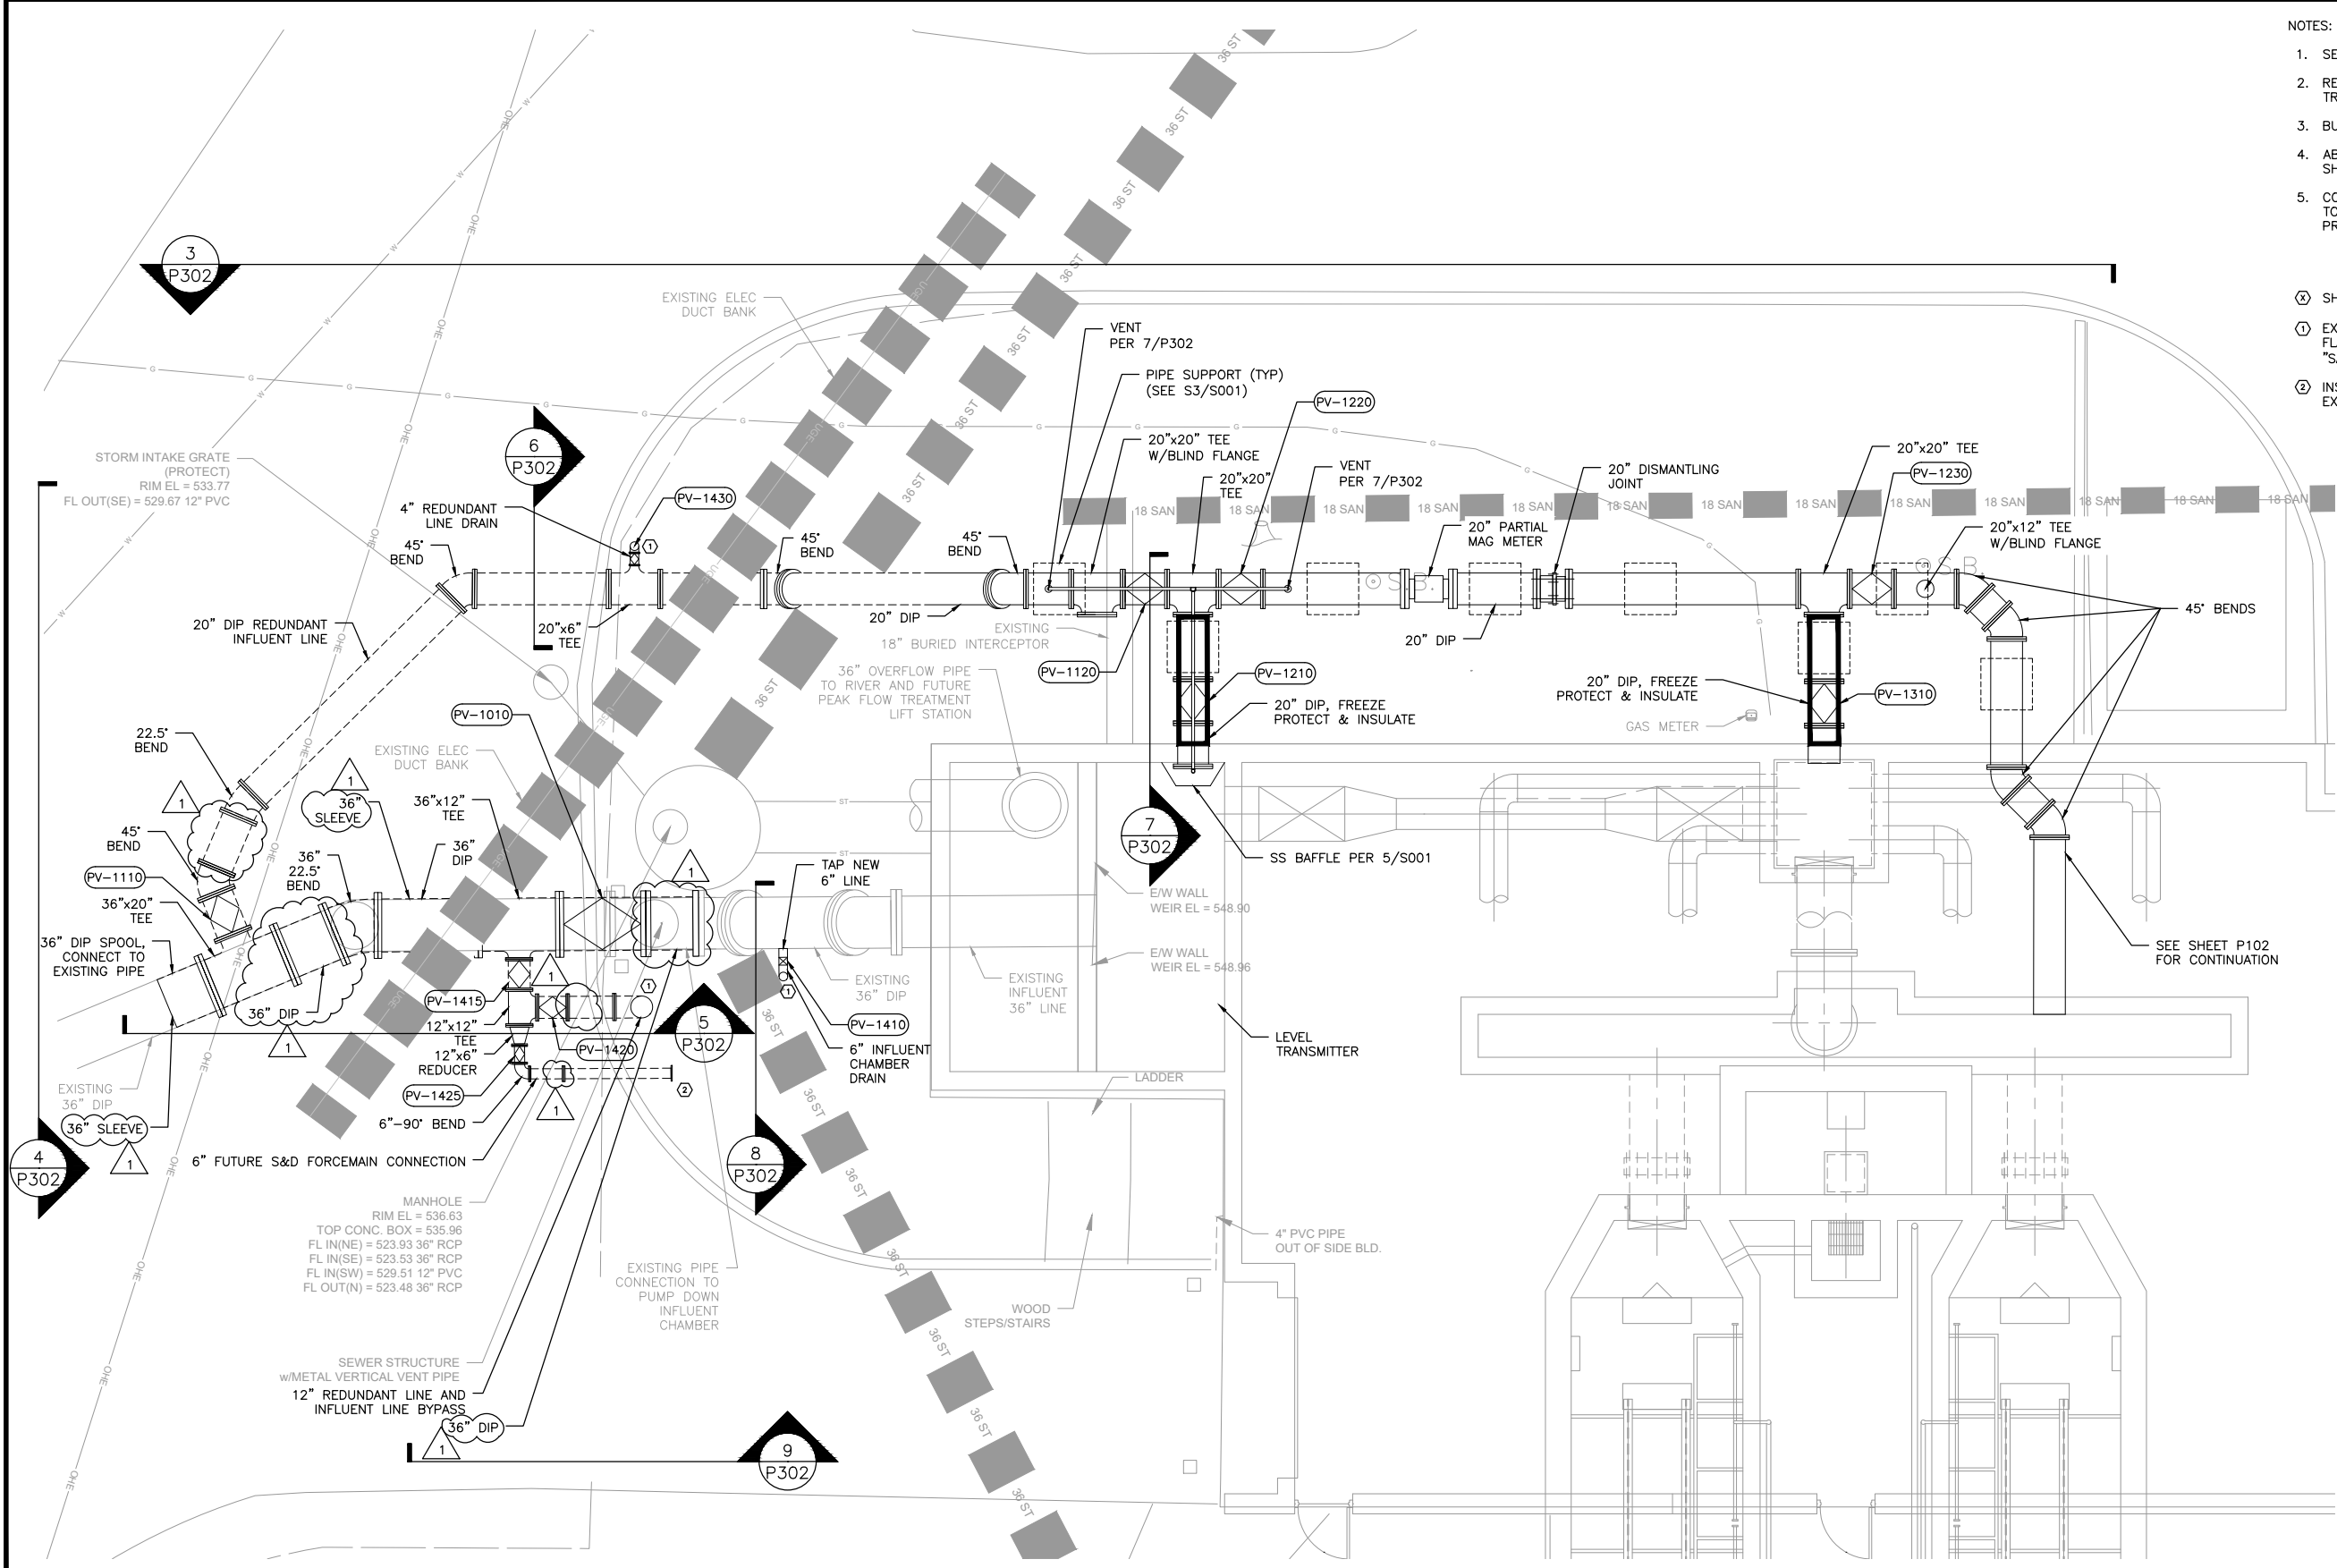

1 PLAN  
SCALE: 1"=5'

1/4/2024 BID SET

DRAWN BY: JMM  
APPROVED: MJW  
CAD DATE: 1/31/2024 3:52:06 PM  
CAD FILE: J:\2022\220608\CAD\Drawings\101 PROCESS PLAN.dwg

JOB DATE: 2023  
JOB NUMBER: 220608

BAR IS ONE INCH ON OFFICIAL DRAWINGS.  
IF NOT ONE INCH, ADJUST SCALE ACCORDINGLY.

NO.	DATE	BY	REVISION DESCRIPTION
1	1/31/24	MJW	ADDENDUM 2




REDUNDANT INFLUENT LINE  
WASTEWATER TREATMENT FACILITY  
BURLINGTON, IOWA


PROCESS  
INFLUENT PIPING - PROCESS PLAN

SHEET NO.  
P101


- ⊗ SHEET P302 KEY NOTES
- ① EXTEND PIPING TO 4" BELOW GRADE. CAP WITH BLIND FLANGE AND INSTALL STANDARD DUTY CASTING MARKED "SANITARY" PER SUDAS SW-203.

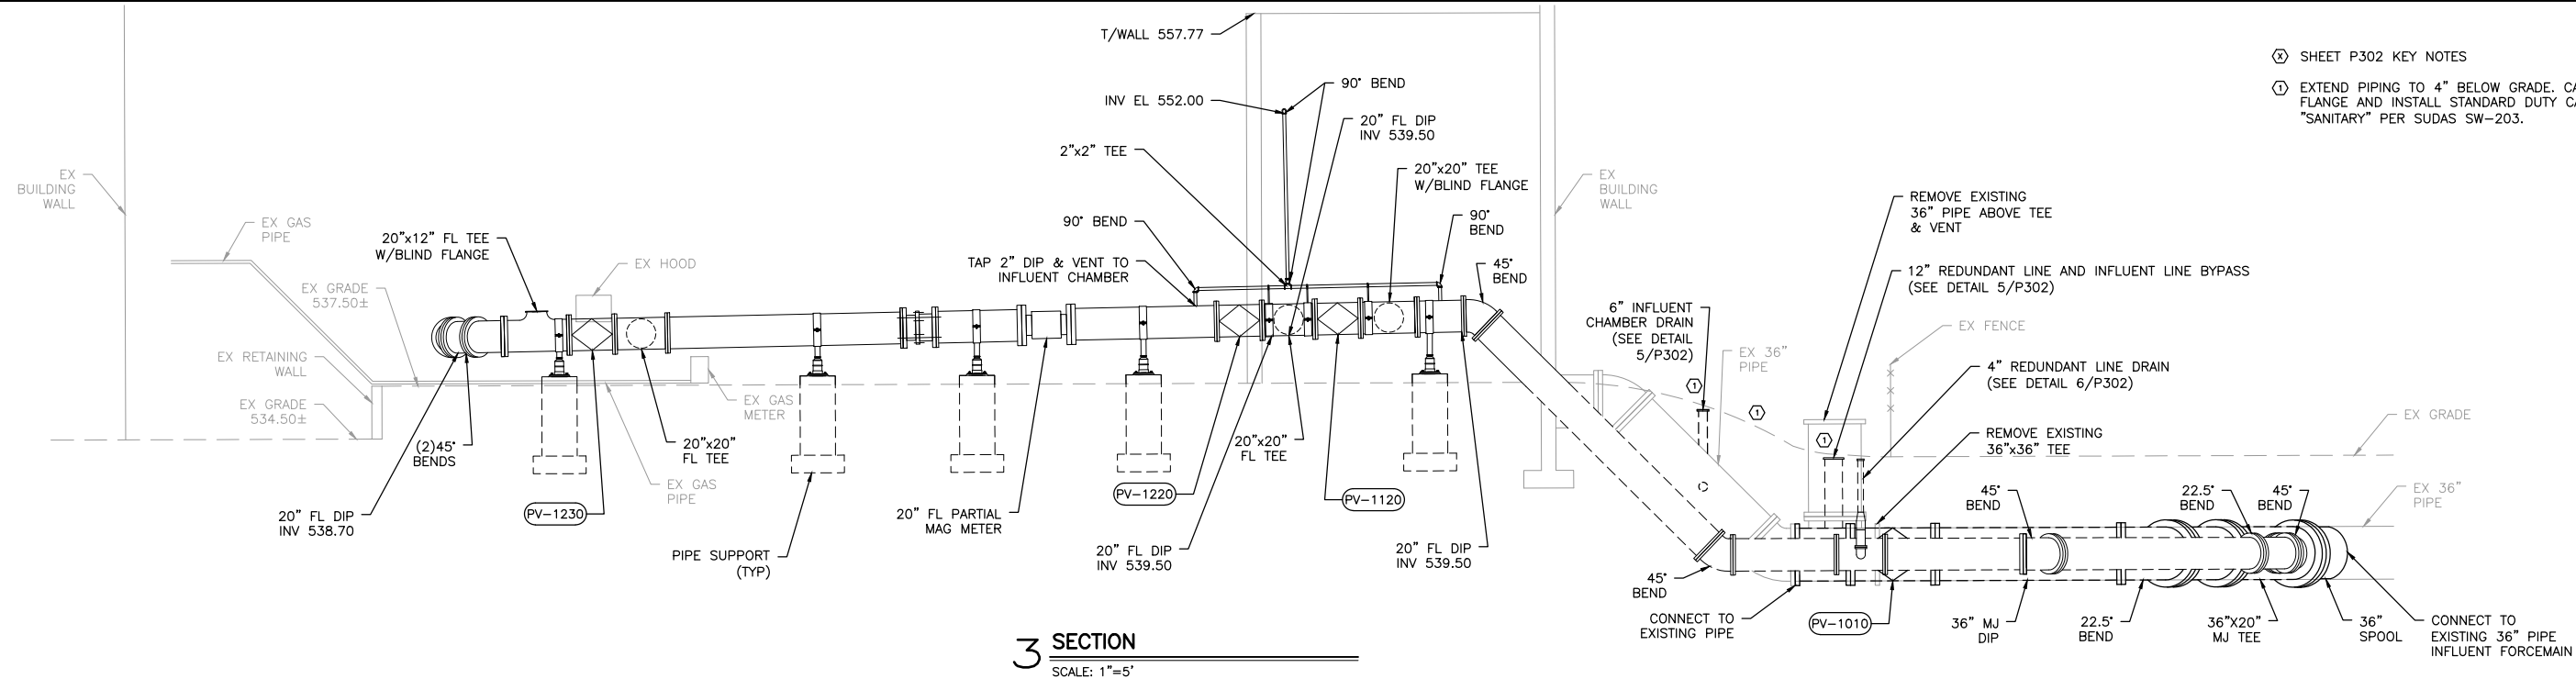


**3 SECTION**  
SCALE: 1"=5'

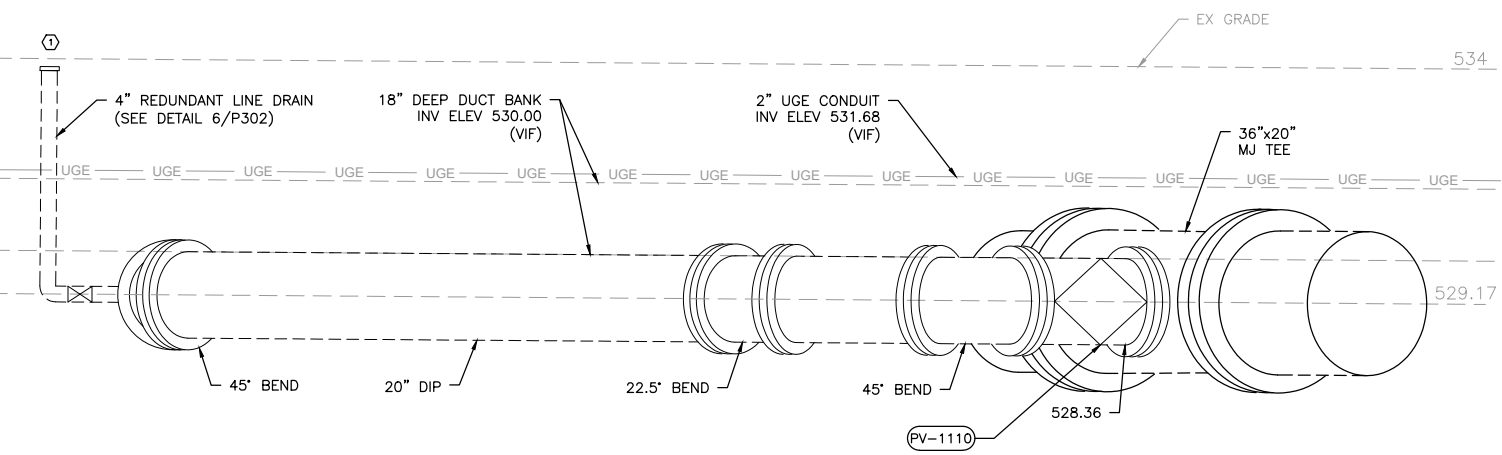


**4 SECTION**  
SCALE: 1"=2'

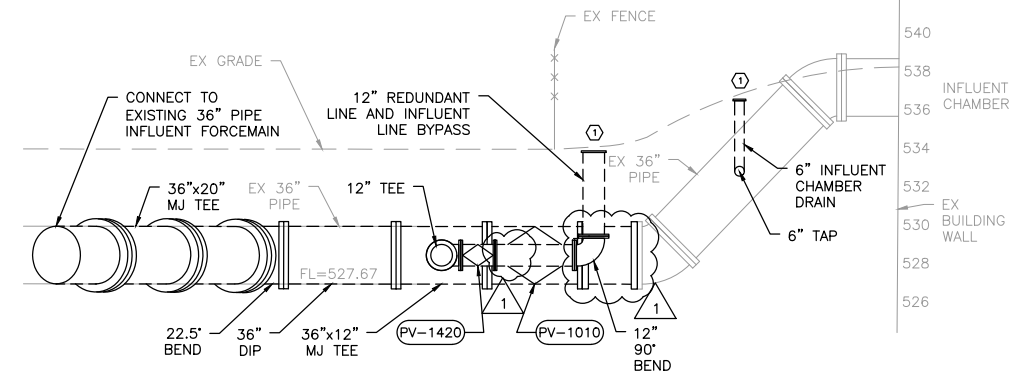


**5 SECTION**  
SCALE: 1"=5'

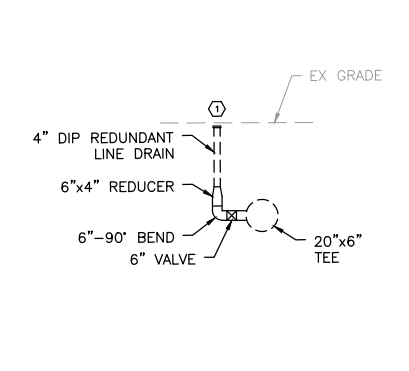


**6 SECTION**  
SCALE: 1"=5'

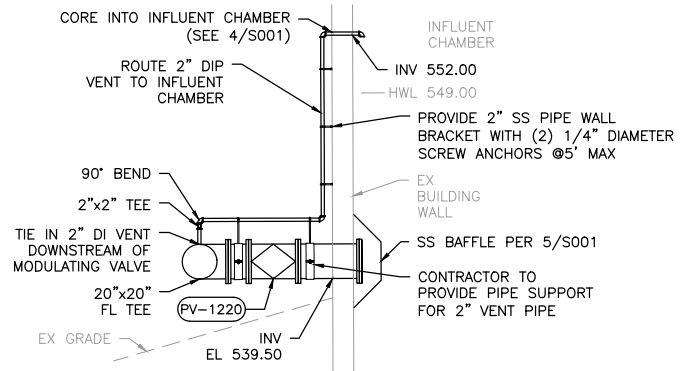

**7 SECTION**  
SCALE: 1"=5'

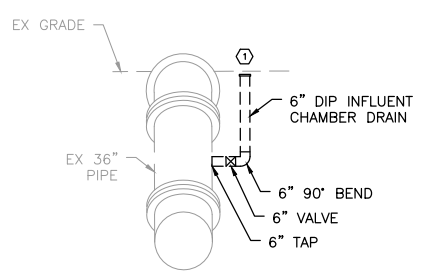

**8 SECTION**  
SCALE: 1"=5'

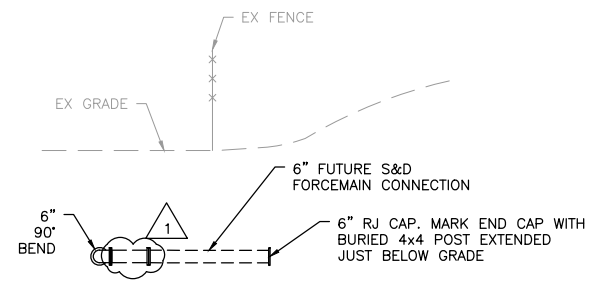

**9 SECTION**  
SCALE: 1"=5'

1/4/2024 BID SET

DRAWN BY: JMM JOB DATE: 2023  
 APPROVED: MJW JOB NUMBER: 220608  
 CAD DATE: 1/31/2024 3:51:34 PM  
 CAD FILE: J:\2022\220608\CAD\Dwgs\P\302.dwg

BAR IS ONE INCH ON OFFICIAL DRAWINGS.  
 IF NOT ONE INCH, ADJUST SCALE ACCORDINGLY.

NO.	DATE	BY	REVISION DESCRIPTION
1	1/31/24	MJW	ADDENDUM 2



REDUNDANT INFLUENT LINE  
 WASTEWATER TREATMENT FACILITY  
 BURLINGTON, IOWA

PROCESS  
 INFLUENT PIPING – PROCESS SECTIONS

SHEET NO.  
**P302**

Xref: xgt-1-dn01: 220608\_PipingScen; xc-0-0-ann; XSX-0-P00 reference

VALVE NO	LOCATION	SIZE	TYPE	OPERATION	SERVICE	NORMAL OPERATION	HIGH FLOWS INTO INFLUENT CHAMBER	BYPASSING INFLUENT CHAMBER TO SCREENING (3)	BYPASSING INFLUENT CHAMBER & SCREENS(3)	DESCRIPTION
PV-1010	OUTSIDE OF INFLUENT CHAMBER	36-INCH	PLUG VALVE	BURIED, 2-INCH SQ NUT	INFLUENT CHAMBER MAIN LINE	OPEN	OPEN	CLOSED	CLOSED	ONLY CLOSED IF BYPASSING THE INFLUENT CHAMBER
PV-1110	OUTSIDE OF INFLUENT CHAMBER	20-INCH	PLUG VALVE	BURIED, 2-INCH SQ NUT	REDUNDANT LINE INFLUENT CHAMBER BYPASS	CLOSED	CLOSED	OPEN	OPEN	ONLY OPEN WHEN BYPASSING THE INFLUENT CHAMBER
PV-1120	OUTSIDE OF INFLUENT CHAMBER	20-INCH	PLUG VALVE	NON BURIED, MANUAL HANDWHEEL	REDUNDANT LINE INFLUENT CHAMBER BYPASS	CLOSED	CLOSED	OPEN	OPEN	ONLY OPEN WHEN BYPASSING THE INFLUENT CHAMBER
PV-1210	OUTSIDE OF INFLUENT CHAMBER	20-INCH	PLUG VALVE	NON BURIED, ACTUATED, ELECT Q/C	INFLUENT CHAMBER REDUNDANT LINE	CLOSED	OPEN (1)	CLOSED (2)	CLOSED (2)	OPENS W/ MODULATING VALVE WHEN INFLUENT CHAMBER REACHES HIGH WATER LEVEL
PV-1220	OUTSIDE OF INFLUENT CHAMBER	20-INCH	PLUG VALVE	NON BURIED, MODULATING, ELECT	INFLUENT CHAMBER REDUNDANT LINE	CLOSED	OPEN (1)	OPEN (1)	OPEN (1)	MODULATES FLOW FROM INFLUENT CHAMBER DURING HIGH WATER
PV-1230	OUTSIDE OF SCREEN BOX	20-INCH	PLUG VALVE	NON BURIED, MANUAL HANDWHEEL	INFLUENT CHAMBER REDUNDANT LINE TO SCREENING CHANNEL	OPEN	OPEN	CLOSED	OPEN (1)	OPENS TO SEND REDUDANT FLOW ABOVE THE SCREENING CAPACITY TO THE SCREENED CHANNEL
PV-1310	OUTSIDE OF SCREEN DISTRIBUTION BOX	20-INCH	PLUG VALVE	NON BURIED, MANUAL HANDWHEEL	INFLUENT CHAMBER REDUNDANT LINE TO SCREENING BOX	CLOSED	CLOSED	OPEN	CLOSED	OPENS TO SEND REDUDANT FLOW BELOW SCREENING CAPACITY TO THE SCREENING BOX
PV-1410	OUTSIDE OF INFLUENT CHAMBER	6-INCH	PLUG VALVE	BURIED, 2-INCH SQ NUT	INFLUENT CHAMBER DRAIN	CLOSED	CLOSED	CLOSED	CLOSED	ONLY OPEN WHEN PUMPING DOWN THE INFLUENT CHAMBER WHILE OFFLINE
PV-1415	OUTSIDE OF INFLUENT CHAMBER	12-INCH	PLUG VALVE	BURIED, 2-INCH SQ NUT	36" INFLUENT CONNECTION TO 12" BYPASS AND 8" S&D FORCEMAIN	OPEN (4)	OPEN (4)	OPEN (4)	OPEN (4)	ONLY OPEN IF OPENING VALVES PV-1420 OR PV-1425. SHALL REMAIN CLOSED UNTIL S&D FORCEMAIN IS INSTALLED OR IF USING PV-1420
PV-1420	OUTSIDE OF INFLUENT CHAMBER	12-INCH	PLUG VALVE	BURIED, 2-INCH SQ NUT	INFLUENT BYPASS FOR BOTH INFLUENT AND REDUNDANT LINES	CLOSED	CLOSED	CLOSED	CLOSED	ONLY OPEN IF INFLUENT CHAMBER AND REDUNDANT LINE ARE OFFLINE. INFLUENT CAN BE PUMPED DOWNSTREAM OF THE SCREENS AND GRIT.
PV-1425	OUTSIDE OF INFLUENT CHAMBER	6-INCH	PLUG VALVE	BURIED, 2-INCH SQ NUT	CONNECTION FOR S&D FORCEMAIN	OPEN (4)	OPEN (4)	OPEN (4)	OPEN (4)	CONNECTS THE S&D LIFT STATION FLOW. SHALL REMAIN CLOSED UNTIL S&D FORCEMAIN IS INSTALLED
PV-1430	OUTSIDE OF INFLUENT CHAMBER	6-INCH	PLUG VALVE	BURIED, 2-INCH SQ NUT	REDUNDANT LINE DRAIN	CLOSED	CLOSED	CLOSED	CLOSED	ONLY OPEN TO DRAIN INFLUENT OR CONDENSATE FROM THE REDUNDANT LINE

- 1 VALVES WILL NEED TO BE MANUALLY CLOSED DURING AN ELECTRICAL OUTAGE
- 2 VALVES WILL NEED TO BE MANUALLY OPENED DURING AN ELECTRICAL OUTAGE
- 3 IF THE INFLUENT CHAMBER IS OFFLINE AND NOT ABLE TO TAKE INFLUENT FLOW, ALL VALVES WILL BE CLOSED AND THE LIFT STATIONS WILL SSO.
- 4 VALVE SHALL REMAIN CLOSED UNTIL THE S&D LINE IS INSTALLED.

WASTEWATER FITTING SCHEDULE		
NUMBER	TYPE	NOTE
0001	36" X 2" D MJR. TEE	
0002	36" X 2" D MJR. TEE	
0003	36" D MJR. 90 DEG BEND	
0004	36" D MJR. 90 DEG BEND	
0005	36" DI M. 90 DEG BEND	2
0006	20" DI 45 DEG BEND	2
0007	20" DI 22 DEG BEND	2
0008	20" DI 45 DEG BEND	2
0009	20" X 3" DI MJR. TEE	
0010	20" DI M. 90 DEG BEND	1
0011	20" DI FLANGED 45 DEG BEND	1
0012	20" X 2" D FLANGED TEE	
0013	20" DI FLANGED 90 DEG BEND	
0014	20" X 2" D FLANGED TEE	
0015	20" X 2" D FLANGED TEE	
0016	20" X 2" D FLANGED TEE	
0017	20" DI FLANGED 45 DEG BEND	2
0018	20" DI FLANGED 45 DEG BEND	2
0019	20" DI FLANGED 45 DEG BEND	1, 2
0020	20" DI FLANGED 45 DEG BEND	1, 2
0021	12" DI M. 90 DEG BEND	2
0022	12" DI BLIND FLANGE	
0023	12" X 1/2" D MJR. TEE	
0024	12" X 3" D MJR. REDUCER	
0025	6" D M. R. 90 DEG BEND	1
0026	6" D M. R. 90 DEG BEND	2
0027	6" D M. R. 90 DEG BEND	1
0028	6" D BLIND FLANGE	
0029	6" D M. R. 90 DEG BEND	1
0030	6" X 4" DI MJR. REDUCER	
0031	4" D BLIND FLANGE	
0032	3" D FLANGED 90 DEG BEND	1
0033	3" D FLANGED 90 DEG BEND	1
0034	3" D FLANGED TEE	
0035	3" D FLANGED 90 DEG BEND	1
0036	3" D FLANGED 90 DEG BEND	1
0037	3" D FLANGED 90 DEG BEND	1
0038	3" D FLANGED 90 DEG BEND	1

NOTES:  
1. VERTICAL BEND  
2. HORIZONTAL BEND

1/4/2024 BID SET

DRAWN BY: JMM JOB DATE: 2023  
 APPROVED: MJW JOB NUMBER: 220608  
 CAD DATE: 1/31/2024 1:40:00 PM  
 CAD FILE: J:\2022\220608\CAD\Dwgs\PA601.dwg

BAR IS ONE INCH ON OFFICIAL DRAWINGS.  
 IF NOT ONE INCH, ADJUST SCALE ACCORDINGLY.

NO.	DATE	BY	REVISION DESCRIPTION
1	1/31/24	MJW	ADDENDUM 2



REDUNDANT INFLUENT LINE  
 WASTEWATER TREATMENT FACILITY  
 BURLINGTON, IOWA

PROCESS  
 VALVE & FITTING SCHEDULE

SHEET NO.  
 P601